


OCR Out

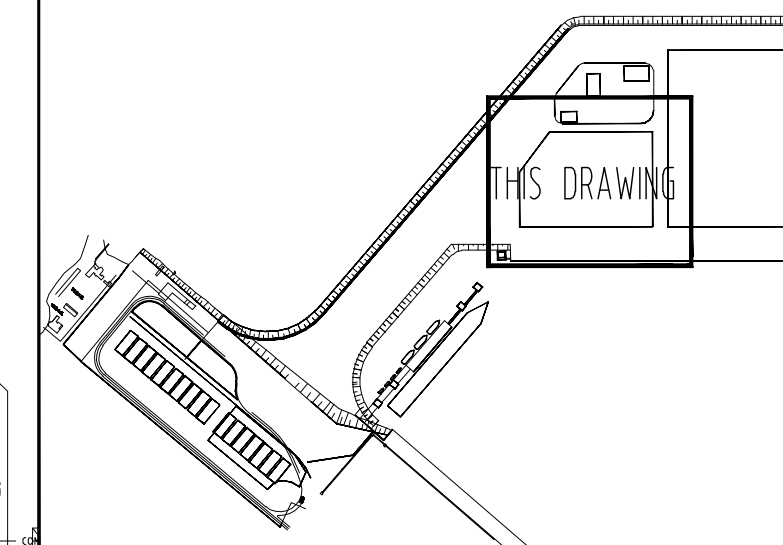

KEY PLAN


NOTES:

- 1.ALL THE DIMENSIONS AND ELEVATIONS ARE IN METERS.
- 2.UPVCØ110 PIPES SHALL BE USED AS COMMUNICATION DUCT.
- 3.COMMUNICATION CABLES SHOULD BE COATED WITH STAINLESS STEEL CASEMENT FOR SHIELDING ELECTROMAGNETIC INTERFERENCE, WHILE COMMUNICATION CABLES ARE LAID IN THE ELECTRICITY CABLE TRENCH.
- 4.MAN HOLES AND HAND HOLES SHALL HAVE CONCRETE FOUADTION.
- 5.IN THE EMPTY LOAD AREA, HXXXB HANDHOLES AND MXXB MANHOLES SHALL BE USED.IN FULL LOAD AREA, HXXXA HANDHOLES AND MXXA MANHOLES SHALL BE USED.
- 6.THE DEPTH OF PIPES SHALL BE 0.8M TO 1.2M.THE GRADE OF PIPES SHALL BE 0.3% TO 0.4%.
- 7.THE THICKNESS OF PIPES SHALL BE 3.0MM, THE ALLOWABLE VARIATION SHALL BE ± 0.2 MM, THE ALLOWABLE VARIATION PORE SIZE IS ± 0.3 MM.



ab	2019.08	AS BUILT	WEN.G	LIAO.M	HUANG.B.C
3	2017.10	FOR CONSTRUCTION			
2	2016.10	FOR CONSTRUCTION			
1	2016.09	FOR CONSTRUCTION			
0	2016.02	FOR CONSTRUCTION			
REV	DATE	DESCRIPTION	BY	CHK.	REV.
APP.					

CLIENT:

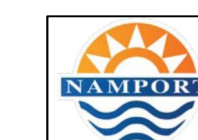

NAMBIAN PORTS AUTHORITY (NAMPOR)

PROJECT:

PORT OF WALVIS BAY NEW
CONTAINER TERMINAL ON RECLAIMED LAND

CONTRACTOR:



CHINA HARBOUR ENGINEERING COMPANY LTD.

TITLE:
COMMUNICATION DUCT LAYOUT
(SHEET 4 OF 9)

SCALE:1:500	DRAWN: WEN.G	DATE: 2019.08
DRAWING No: E-CN-DR-2204		REV: ab

ITEM	TITLE	ITEM	TITLE	ITEM	TITLE	ITEM	TITLE
COM	COMMUNICATION DUCT	HXXXA	COMMUNICATION HANDHOLE FULL LOAD	MXXA	LARGE SIZE COMMUNICATION MANHOLE, FULL LOAD		PIT, PROVIDED BY ELECTRIC
HXXXB	COMMUNICATION HANDHOLE EMPTY LOAD	MXXB	LARGE SIZE COMMUNICATION MANHOLE, EMPTY LOAD		HIGH MAST LIGHTING		WIRELESS POLE