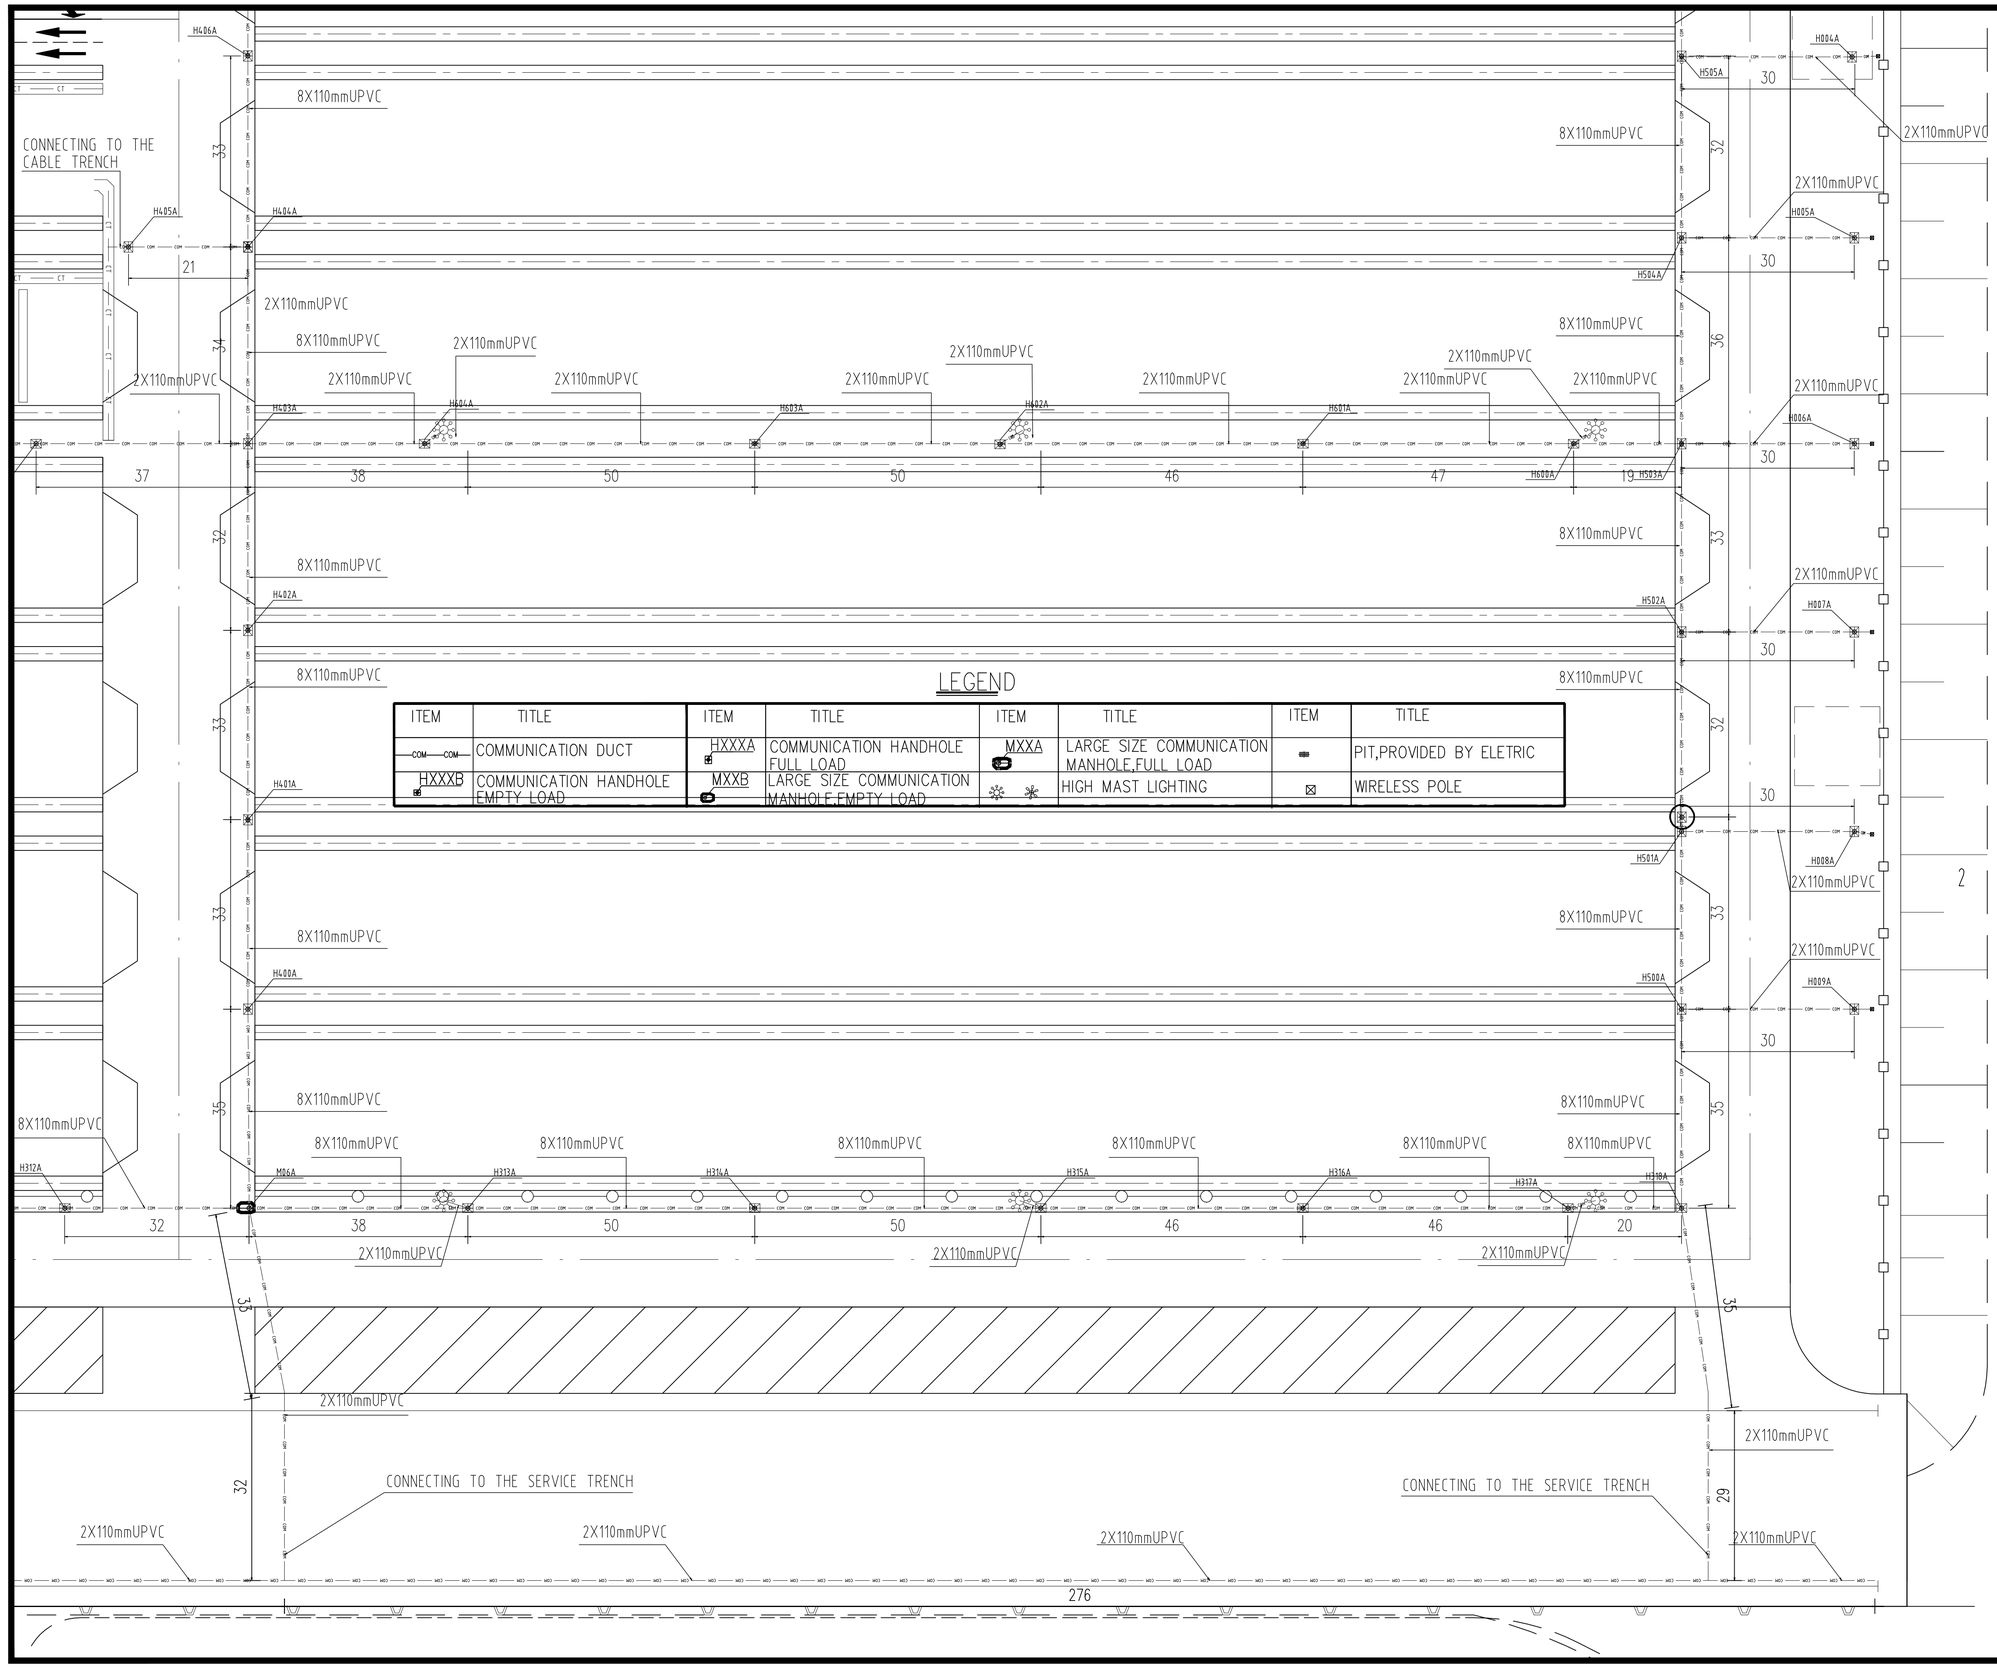

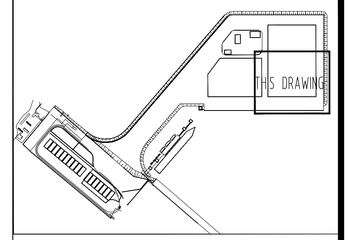

KEY PLAN

NOTES:

1.ALL THE DIMENSIONS AND ELEVATIONS ARE IN METERS.

2.UPVCø110 PIPES SHALL BE USED AS COMMUNICATION DUCT.

3.COMMUNICATION CABLES SHOULD BE COATED WITH STAINLESS STEEL CASEMENT FOR SHIELDING ELECTROMAGNETIC INTERFERENCE, WHILE COMMUNICATION CABLES ARE LAID IN THE ELECTRICITY CABLE TRENCH.

4.MAN HOLES AND HAND HOLES SHALL HAVE CONCRETE FOUDATION.

5.IN THE EMPTY LOAD AREA, HXXXB HANDHOLES AND MXXB MANHOLES SHALL BE USED.IN FULL LOAD AREA, HXXXA HANDHOLES AND MXXA MANHOLES SHALL BE USED.

6.THE DEPTH OF PIPES SHALL BE 0.8M TO 1.2M.THE GRADE OF PIPES SHALL BE 0.3% TO 0.4%.

7.THE THICKNESS OF PIPES SHALL BE 3.0MM, THE ALLOWABLE VARIATION SHALL BE ± 0.2MM, THE ALLOWABLE VARIATION PORE SIZE IS ± 0.3MM.

REV	DATE	DESCRIPTION	BY	CHK.	REV.	APP.
ab	2019.08	AS BUILT	WEN.G	LIAO.M		HUANG.B.G
3	2017.10	FOR CONSTRUCTION				
2	2016.10	FOR CONSTRUCTION				
1	2016.09	FOR CONSTRUCTION				
0	2016.02	FOR CONSTRUCTION				

CLIENT:

NAMIBIAN PORTS AUTHORITY (NAMPORT)

PROJECT:

PORT OF WALVIS BAY NEW CONTAINER TERMINAL ON RECLAIMED LAND

CONTRACTOR:

CHINA HARBOUR ENGINEERING COMPANY LTD.

TITLE:

COMMUNICATION DUCT LAYOUT (SHEET 5 OF 9)

SCALE:1:500	DRAWN: WEN.G	DATE: 2019.08	
DRAWING No: E-CN-DR-2205			REV: ab