
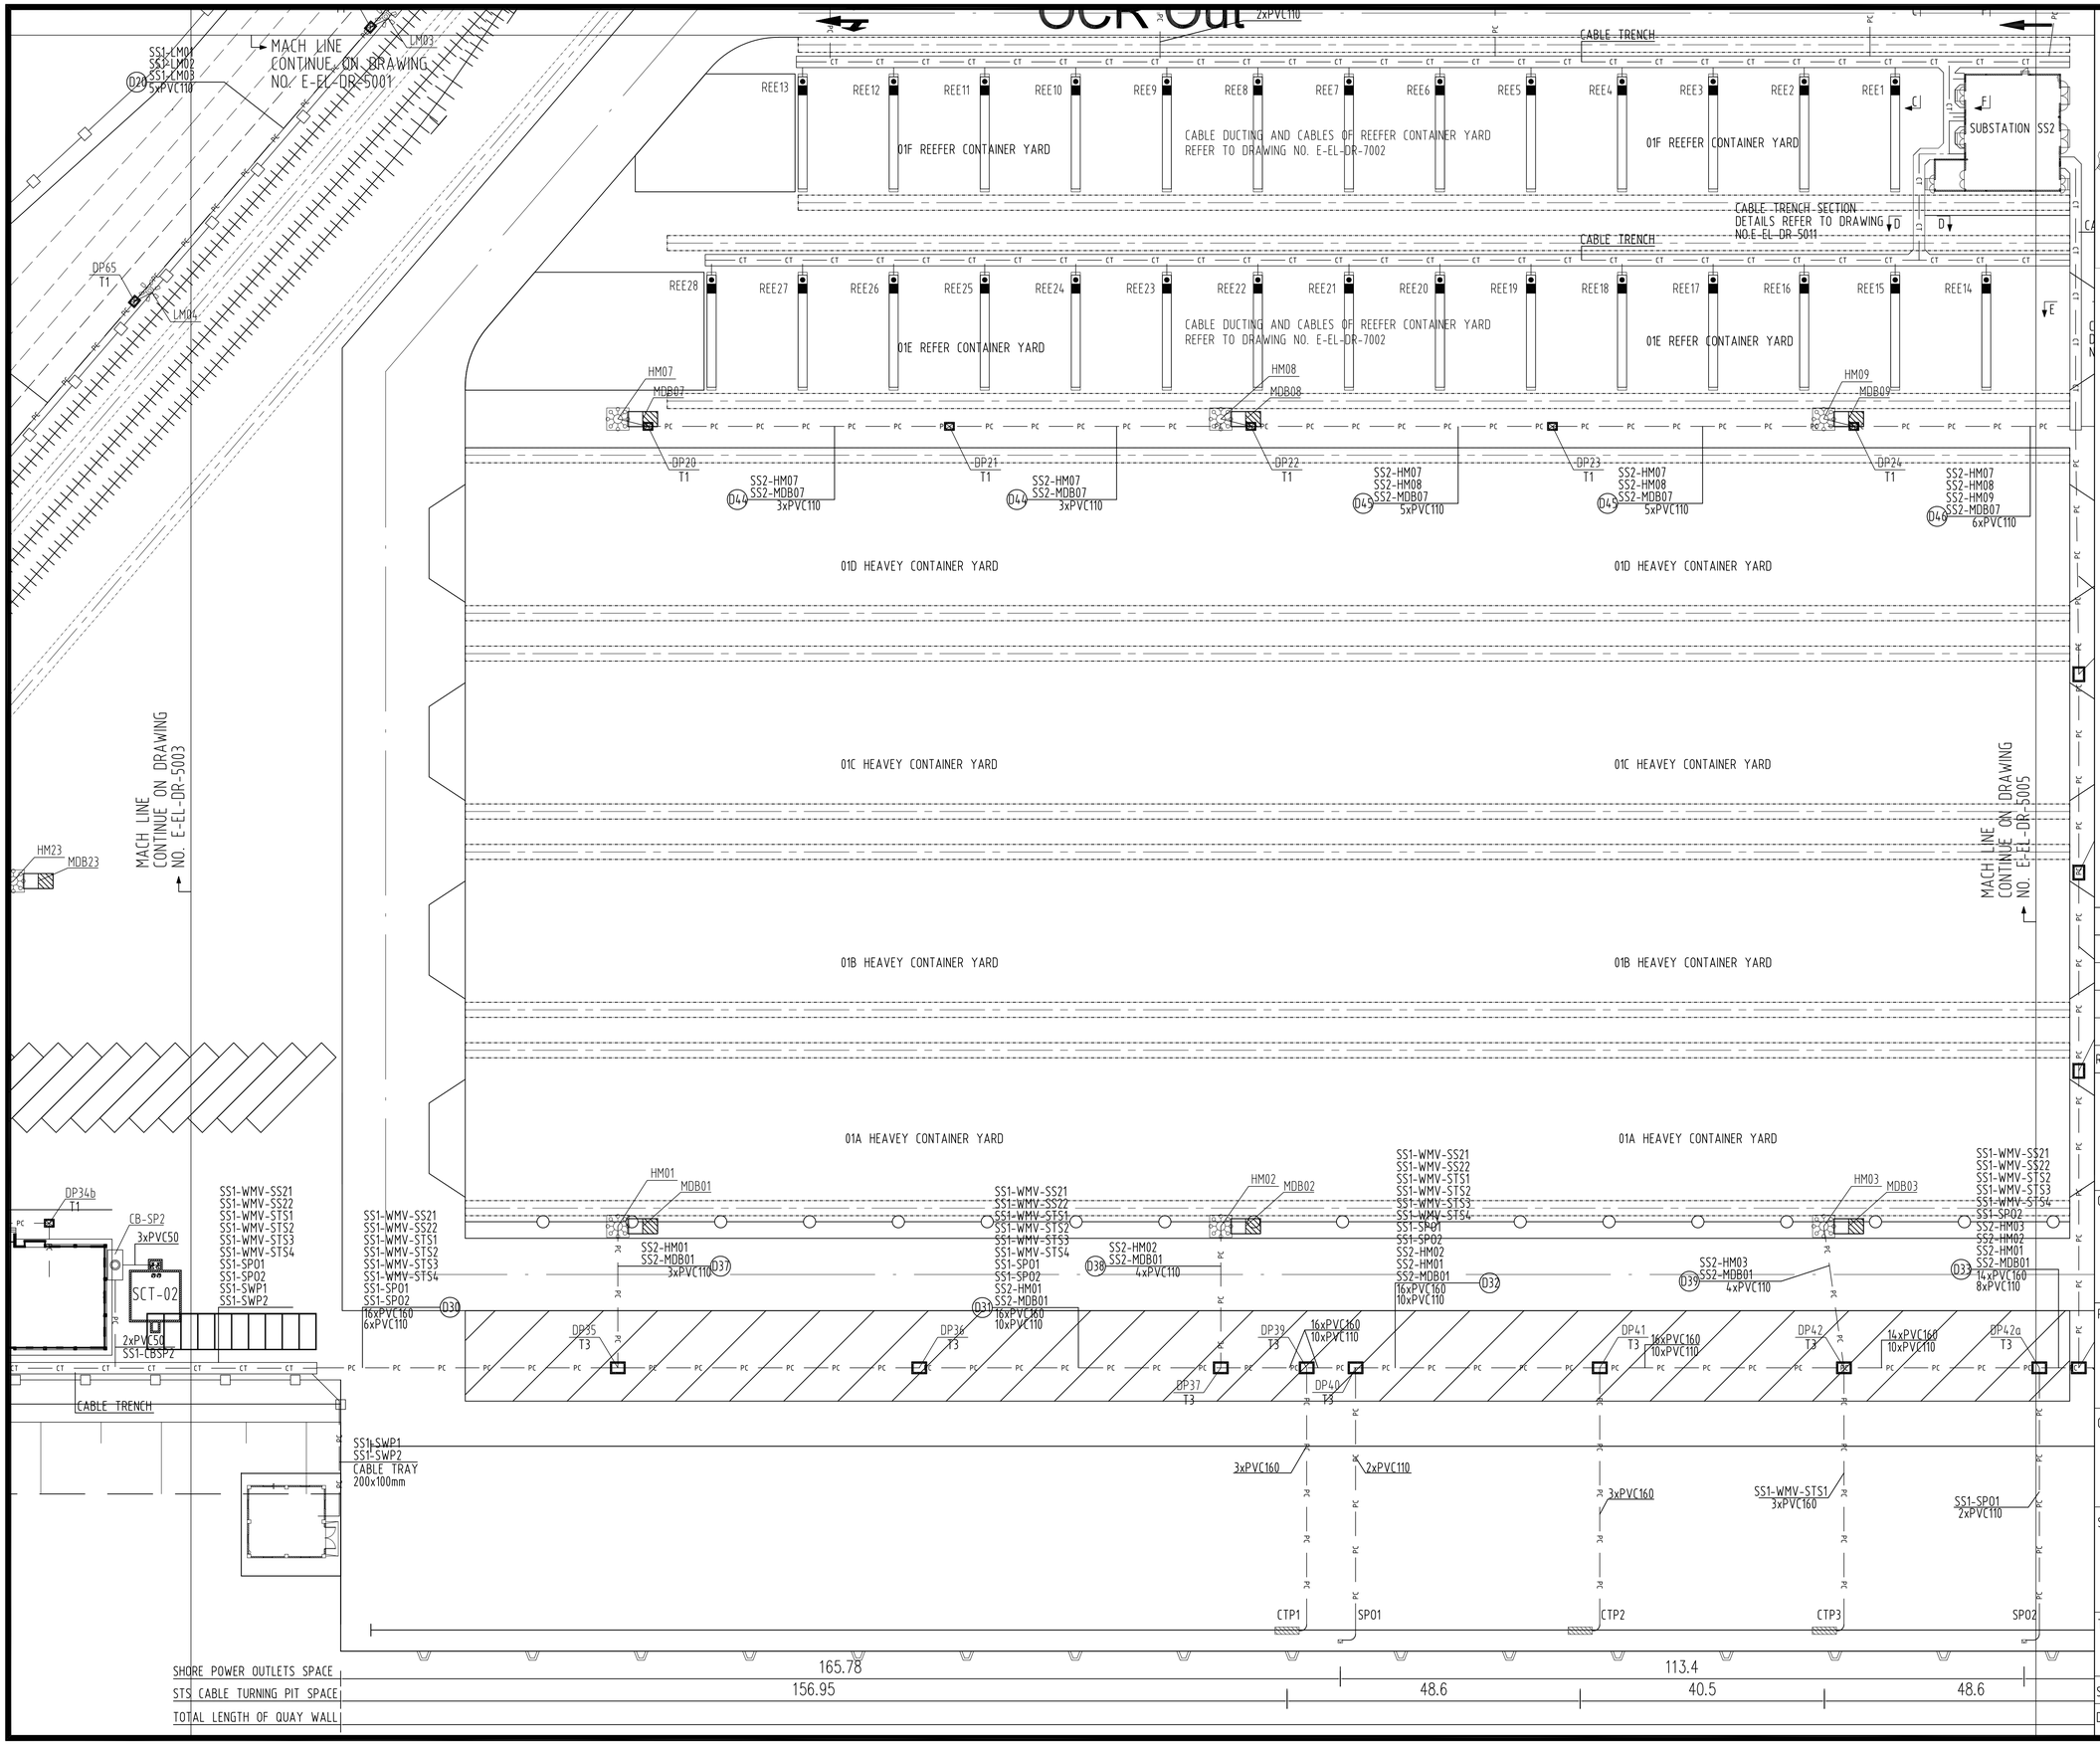


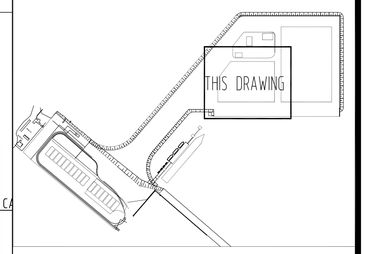

KEY PLAN

NOTE:
1. ALL DIMENSIONS ARE IN METRES UNLESS NOTED OTHERWISE.
2. ALL LEVELS ARE IN METRES UNLESS NOTED OTHERWISE.
3. EXACT COORDINATES OF LIGHTING MASTS/DRAWPITS/CABLE TRENCH REFER TO TERMINAL LAYOUT DRAWINGS.
4. THE DEPTH FROM THE CENTER OF BURIED DUCTS TO FINISHED GROUND LEVEL SHALL BE NOT LESS THAN 0.7m FOR 0.6/1kV CABLE DUCTS AND 1m FOR 6.35/11kV CABLE DUCTS. THE BURIED DEPTH FOR CABLE DUCTS WHERE CROSS THE RAILWAY SHALL BE NOT LESS THAN 1m.
5. CABLE DUCTS SHALL BE SURROUNDED WITH C20 CONCRETE(DETAILS REFER TO DRAWING NO. 'E-EL-DR-5012'TO 'E-EL-DR-5018').
6. THE CABLE PIT AND DUCT DESIGN HAS YET TO BE FINALIZED TO SUIT ERONGO RED'S INCOMING SUPPLY CABLES.

NAMIBIAN PORTS AUTHORITY
P.O. BOX 212 Walvis Bay Namibia
Elzevir Gelderbloem
PORT ENGINEER

1:500 0 5 20 40m

REV.	DATE	DESCRIPTION	DESIGNED	CHECKED	APPROVED	SIGNED
ab	2019.08	AS BUILT	WEN.G	LIAO.M	HUANG.B.G	
3	2018.05	FOR CONSTRUCTION	HE.H	ZHANG.Z.Y.		
2	2017.08	FOR CONSTRUCTION	HE.H	ZHANG.Z.Y.		
1	2016.11	FOR CONSTRUCTION	HE.H	ZHANG.Z.Y.		
0	2016.06	FOR CONSTRUCTION	HE.H	ZHANG.Z.Y.		

CLIENT APROVAL

NAME:
RANK:
SIGNED:
DATE:
STAMP:

CLIENT:
NAMIBIAN PORTS AUTHORITY (NAMPORT)

PROJECT:
NEW PORT OF WALVIS BAY
CONTAINER TERMINAL ON RECLAIMED LAND

CONTRACTOR:
CHINA HARBOUR ENGINEERING COMPANY LTD.

SUBCONSULTANT:
G.S. FAINSINGER & ASSOCIATES

TITLE:
ELECTRICAL INSTALLATION LAYOUT PLAN
(SHEET 4 OF 9)

SCALE:1:500	DRAWN:HE.H	DATE: 2018.05	
DRAWING No: E-EL-DR-5004			REV: ab